


PLAN
SCALE 1

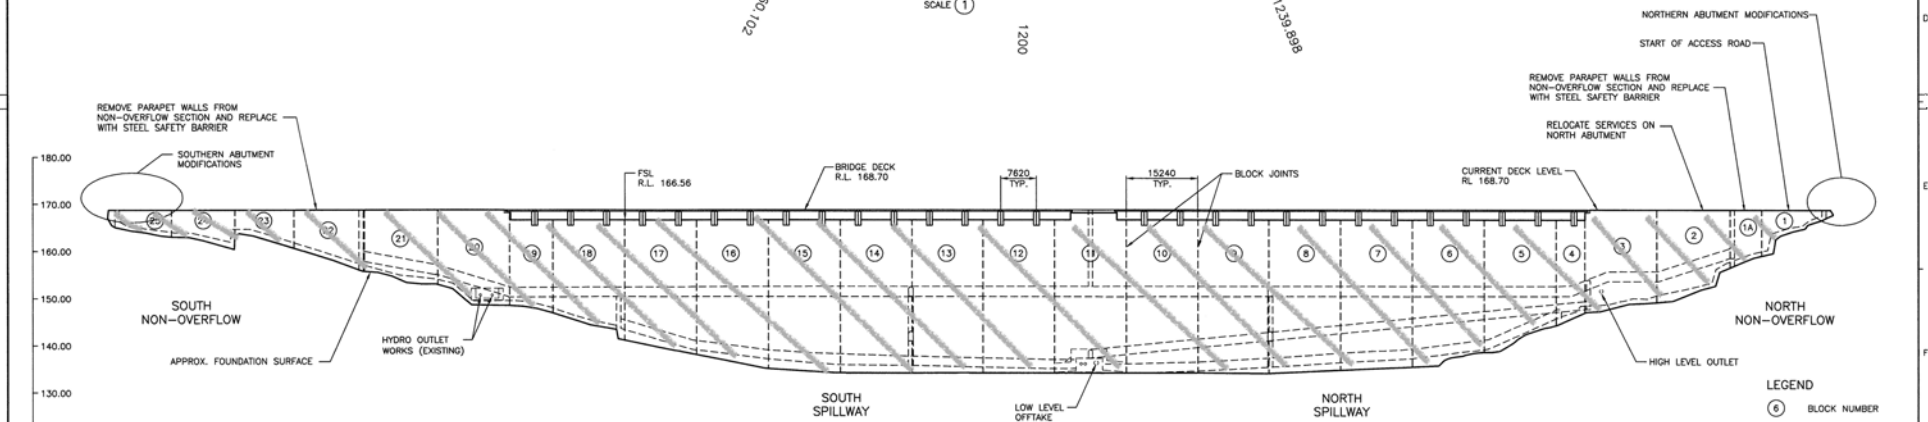


VIEW A
SCALE 1

AS CONSTRUCTED
GARRY BLOXHAM DATE: 12-2011
CONTRACTOR'S PROJECT MANAGER 12-2011

AS CONSTRUCTED INFORMATION INDICATED IN *Italic*

ALL DESIGN INFORMATION SHOWN UNCHANGED IS DEEMED TO BE AS CONSTRUCTED

DEPARTMENT OF PLANNING, LANDS AND HERITAGE
DATE: 01-Apr-2020 FILE: 609-10-1

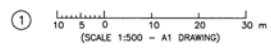

SERVICES - RELOCATION GENERAL ARRANGEMENT	JR00-41-1
GENERAL NOTES	JR00-33-1
ACCESS ROAD - NORTH ABUTMENT - GENERAL ARRANGEMENT	JR00-30-1
GALLERY MODIFICATIONS - GENERAL ARRANGEMENT	JR00-19-1
NON-OVERFLOW DECK WIDENING - GENERAL ARRANGEMENT	JR00-17-50
SPILLWAY BRIDGE DECK - GENERAL ARRANGEMENT	JR00-17-1
INSTRUMENTATION - GENERAL ARRANGEMENT	JR00-18-1
POST-TENSIONED ANCHORING SYSTEM - GENERAL ARRANGEMENT - SHEET 1 OF 3	JR00-9-1
DAM - GEOMETRICS DATA	JR00-5-5
DAM - TYPICAL CROSS SECTIONS	JR00-5-4
SITE LAYOUT	JR00-5-2
LOCALITY PLAN	JR00-5-1
DRAWING INDEX	JR00-1-1
REFERENCE DRAWINGS	DRAWING No.

ISSUE	DATE	GRID	REVISION	DRN	REC	APPD
B	12/2011		AS CONSTRUCTED PLOTTED FROM INFORMATION SUPPLIED BY WELLINGTON DAM ALLIANCE			

DESIGN SURVEY	VERTICAL DATUM	DES CALC	NORTH POINT
NONE	AID	P. SOUTHGOTT	
ASCON SURVEY	COORDINATE SYS	DES CHD	
NONE	PCGS4	A.H. HARMAN	
	DES REF	DRN	
		R. HEMINGTON	
		G.C. CHD	
		G. HUNTER	



RECOMMENDED	14/09/2010
A. H. HARMAN	
DESIGN MANAGER	
APPROVED	14/09/2010
B. JOHNSTON	
ALLIANCE MANAGER	



SOUTH WEST REGION WELLINGTON DAM REMEDIAL WORKS GENERAL DAM - GENERAL ARRANGEMENT	
FILE	J11 2007 07747 V01 PLAN
PROJECT	C-W01049
CAD	JR00-5-3
ISSUE	B
DATE	15 MAR 2012

ORIGINAL SHEET SIZE: A1